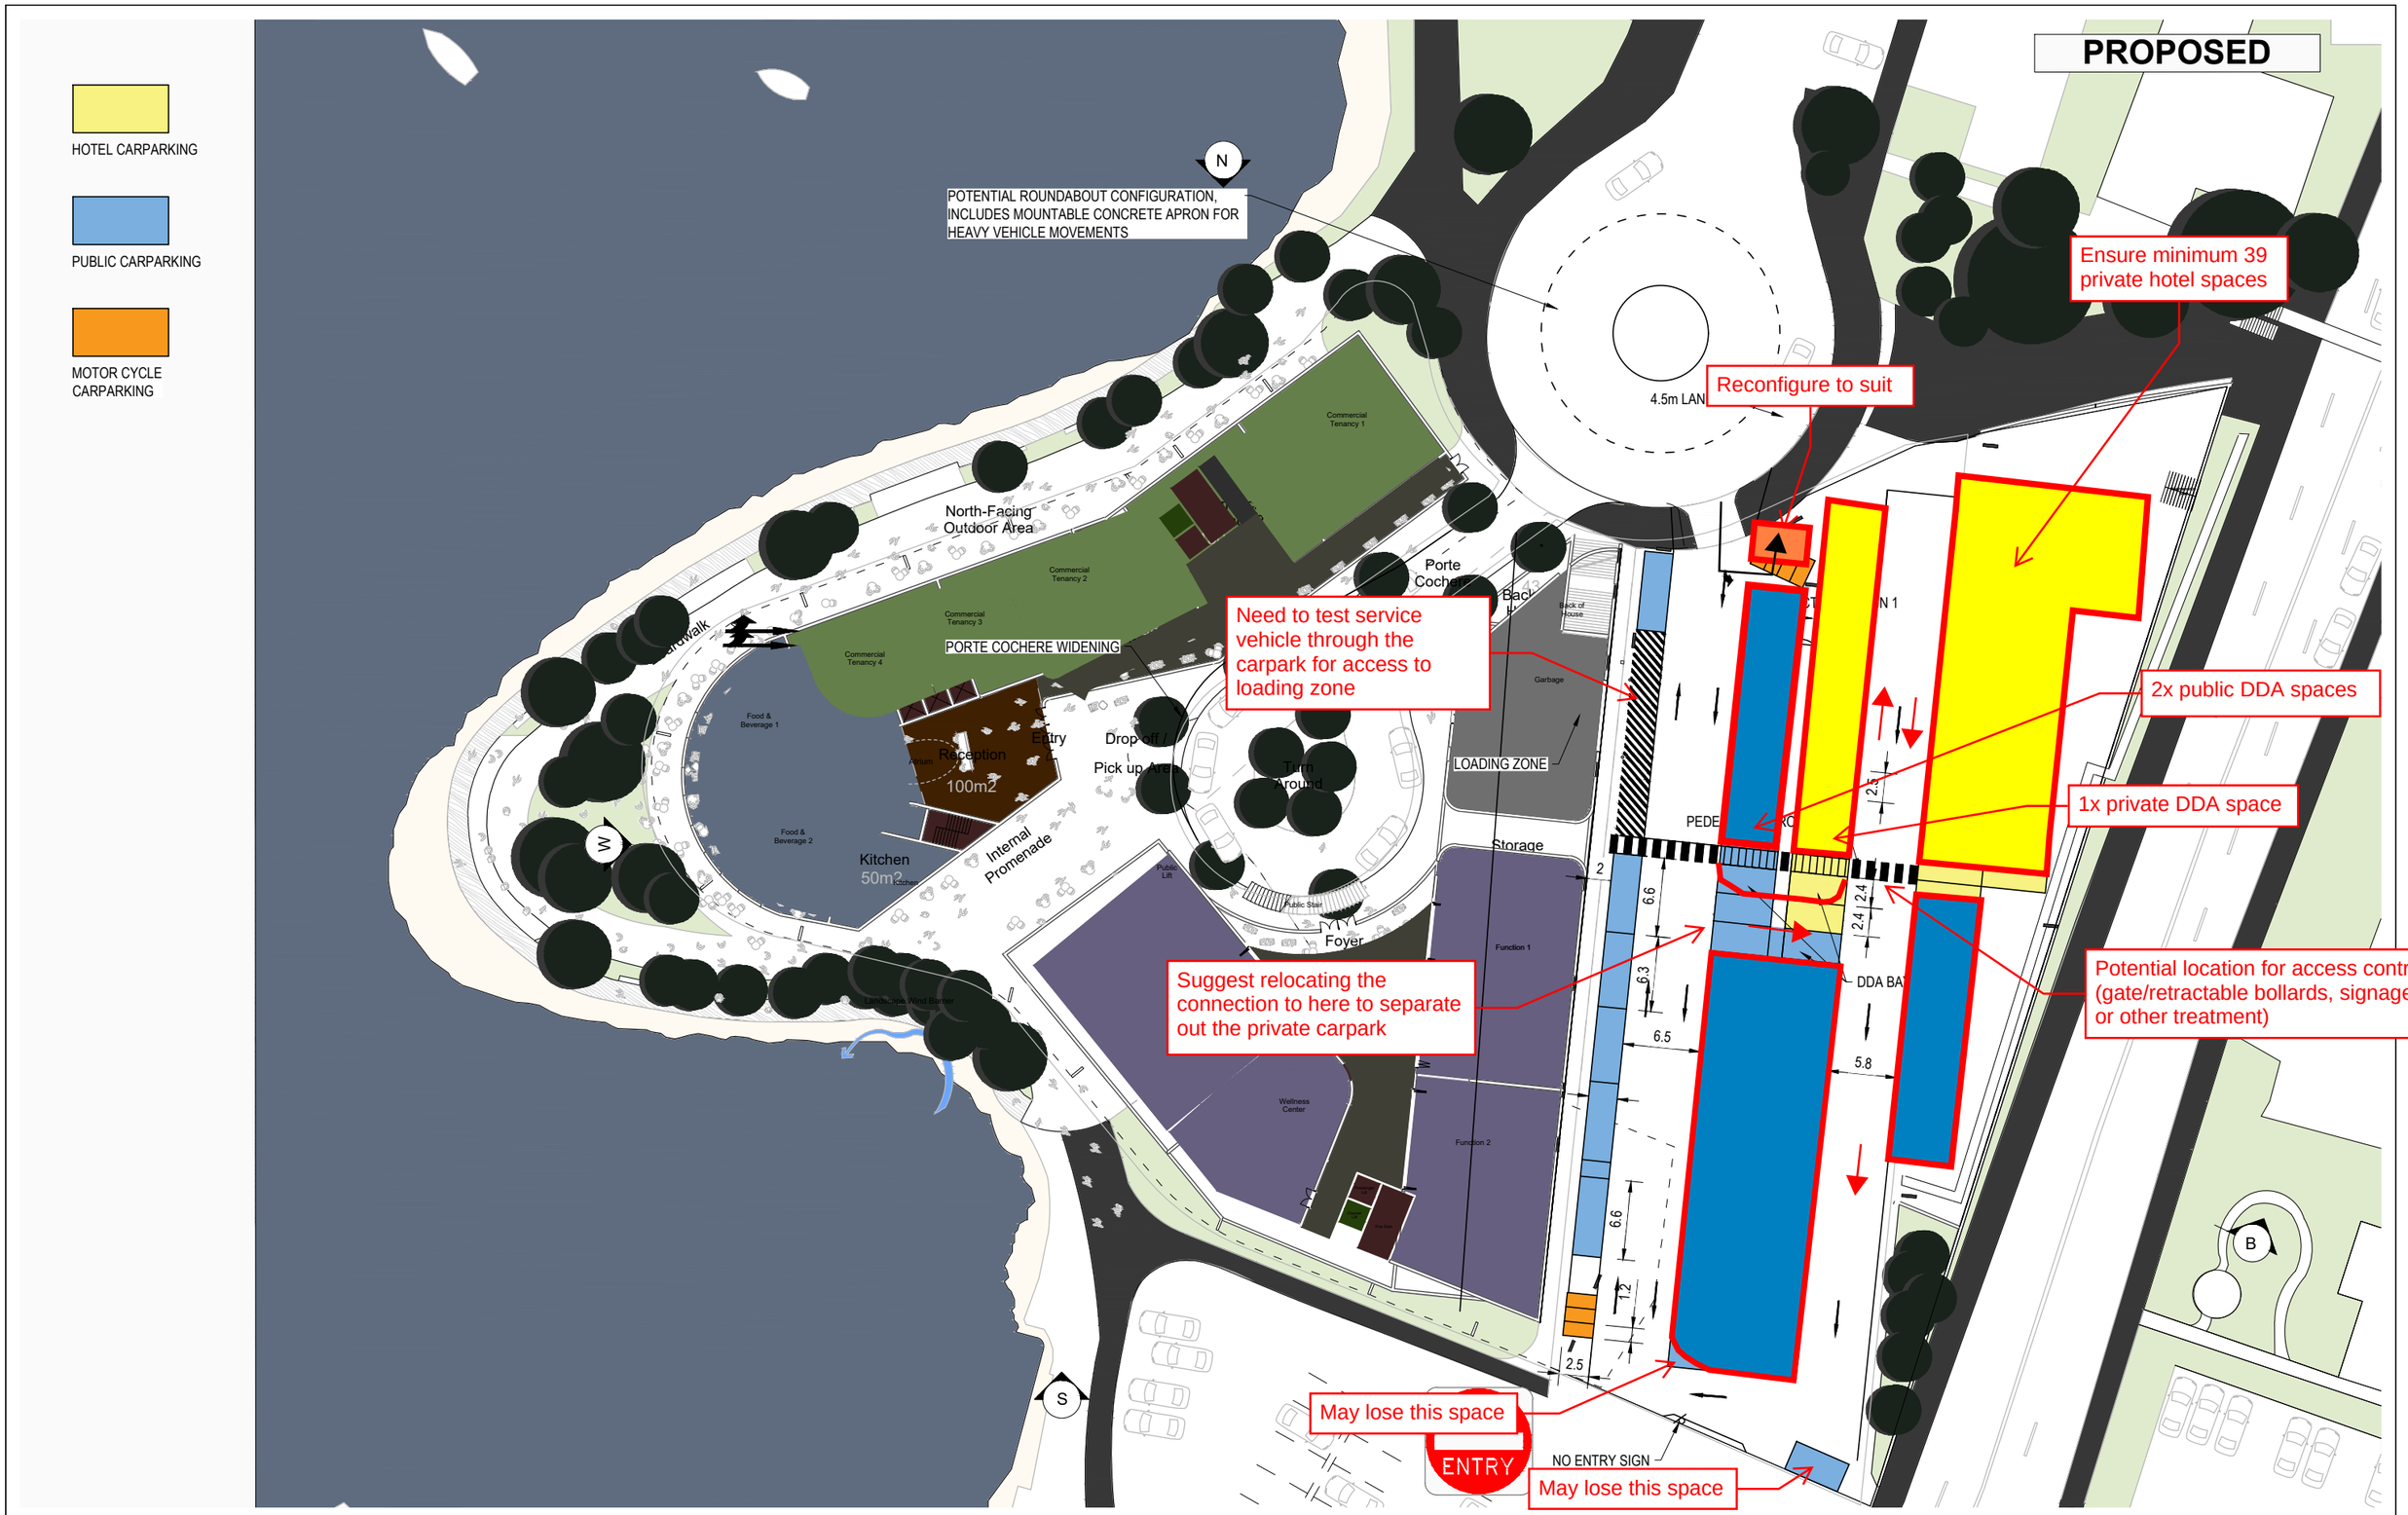

DRAWING REVISION HISTORY					
No.	DESCRIPTION	DRAWN	DESIGNED	REVIEWED	DATE
A	FOR INFORMATION	CM	CM	RR	31/10/2025

APPROVED

ORIGINAL COPY ON FILE "e" SIGNED BY

SIGNED

DATE

SCALE (PLOTTED FULL SIZE): AS SHOWN

SHEET SIZE: A3

5 0 5 10 15 20

SCALE IN METRES - 1:500

pitt&sherry

pittsh.com.au Phone 1300 748 874 ABN 67 140 184 309

© 2023 PITT & SHERRY (OPERATIONS) PTY LTD. THE DOCUMENT MAY ONLY BE USED FOR THE PURPOSE FOR WHICH IT WAS COMMISSIONED AND IN ACCORDANCE WITH THE TERMS OF ENGAGEMENT.

CLIENT: CHAMBROAD

PROJECT: KANGAROO BAY HOTEL

STATUS: **PRELIMINARY**

DRAWING TITLE: CAR PARK GENERAL ARRANGEMENT

DATUMS: AHD / MGA

CLIENT No.: -

DRAWING No.: S-P.23.0373-00-CIV-SKT-5001

REVISION: A

PRINT IN COLOUR

Aug. 6, 26 - 11:41:07 Name: S-P.23.0373-00-CIV-SKT-5001.dwg